

Work Order ID 143353

Tuesday, March 15, 2016 9:20:44 AM

143353

Page 1

Item ID: D4151-5

Accept

N900040100

Setup Start *NS1*

Revision ID:

Item Name: Fwd Basket Instl Stud

Stop *NS2*

Start Date: 3/24/2016 **Start Qty:** 20.00

20

Cust Item ID:

Required Date: 4/1/2016 **Req'd Qty:** 20.00

20

Customer:

Reference:

Approvals:

Process Plan: M C J

Date: MAR 15 2016

Tooling:

Date:

Run Start *NR1*

QC:

Date:

SPC (Y/N):

Date:

Stop *NR2*

[illegible]

DQA: _____ Date: _____



WORK ORDER NON-CONFORMANCE / UPDATE

QA Closed: _____ Date: _____

Work Order update only ☐

Work Order: _____ Part No. _____ NCR No. _____		DISPOSITION Rework ☐ Scrap ☐ Use-as-is ☐ Suspected Unapproved ☐		AGAINST DEPARTMENT/PROCESS Skid-tube ☐ Machining ☐ Thermoforming ☐ Large Fab ☐ Cross tube ☐ Small Fab ☐ Finishing ☐ Composite ☐ Water Jet ☐ Prod. Eng. Coord. ☐ Rec/Store/Packaging ☐ Supplier ☐ Engineering ☐ Quality ☐ Other ☐					
Date :		Step #:		QTY Effective :			MRB (QSI042) Approval		
Description Work Order Deviation				Disposition				Completed By	
								Lead hand / Supervisor Approval Verification	
Root Cause		FAULT CATEGORY							
Environment ☐	No Re-verification ☐	Pressure/Forced ☐	Temperature/Cure ☐	Power Loss/Surge ☐	Positioned Wrong ☐				
Design ☐	Operator ☐	Bending ☐	Set-up ☐	Folio/Program ☐	Outside Dimensions ☐				
Doc/Data ☐	Offset/Setup ☐	Centre Not Concentric ☐	BOM/Route ☐	Grain ☐	Over/Under tolerance ☐				
Equip/Tooling ☐	Supplier ☐	Cracks ☐	Broken/Damage/Defect ☐	Weld ☐	Part Incorrect ☐				
Handling/Pre ☐	Training ☐	Crimp/Kink/Ripple/Wave ☐	Inspection Incomplete/Unqualified ☐	Wrong Stock Pulled ☐	Part Lost/Missing ☐				
Material ☐	Use for Testing ☐	Cuffs ☐	Contamination ☐	Out of Sequence ☐	Part Moved ☐				
Internal Transport ☐	Poor Information ☐	Crushing ☐	Countersink ☐	Off-set ☐	Drawing ☐				
Tribal Knowledge ☐	Rushing ☐	Heat Treat ☐	Cut Too Short ☐	Mislabeled ☐	Finish ☐				
LOA ☐	Product Improvement ☐	Wave/Twist in Tube ☐	Instructions Incomplete/Unclear ☐	Fit/Function ☐	Misread ☐				
Substation ☐	Process Improvement ☐	Marks/Chatter ☐	Drill Holes ☐	Misaligned/off center ☐	Turning Sequence ☐				
Past Expiry Date ☐	Manufacturing Process ☐	OTHER : _____							
Misidentified ☐	Past Due ☐								

Work Order ID 143353

Tuesday, March 15, 2016 9:20:44 AM

143353

Page 2

Item ID: D4151-5 Accept ***N900040100*** Setup Start ***NS1***
Revision ID: Stop ***NS2***
Item Name: Fwd Basket Instl Stud
Start Date: 3/24/2016 Start Qty: 20.00 ***20*** Cust Item ID:
Required Date: 4/1/2016 Req'd Qty: 20.00 ***20*** Customer:
Reference:

Approvals: Process Plan: _____ Date: _____ Tooling: _____ Date: _____ Run Start ***NR1***
QC: _____ Date: _____ SPC (Y/N): _____ Date: _____ Stop ***NR2***

Sequence ID/ Work Center ID	Operation Description	Set Up/ Run Hours	Tool ID	Tool #	Plan Code	Accept Qty	Reject Qty	Reject Number	Insp. Stamp
130	QC8- Inspect parts - second check	0.00							
130						20	0		16/04/08
QC	Memo	0.01							DAS
Quality Control									14/04/09
									9-89
140	Identify as per dwg & Stock Location: <u>ST087</u>	0.00							
140						20			MW 1604-12
Packaging	Memo	0.00							
Packaging									
150	QC21- Final Inspection - Work Order Release	0.00							
150									
QC	Memo	0.03							MW
Quality Control									APR 12 2016

MW APR 12 2016

DQA: _____ Date: _____



WORK ORDER NON-CONFORMANCE / UPDATE

QA Closed: _____ Date: _____

Work Order update only ☐

Work Order: _____ Part No. _____ NCR No. _____		DISPOSITION Rework ☐ Scrap ☐ Use-as-is ☐ Suspected Unapproved ☐		AGAINST DEPARTMENT/PROCESS Skid-tube ☐ Machining ☐ Thermoforming ☐ Large Fab ☐ Cross tube ☐ Small Fab ☐ Finishing ☐ Composite ☐ Water Jet ☐ Prod. Eng. Coord. ☐ Rec/Store/Packaging ☐ Supplier ☐ Engineering ☐ Quality ☐ Other ☐					
Date :		Step #:		QTY Effective :			MRB (QS1042) Approval		
Description Work Order Deviation				Disposition				Completed By Lead hand / Supervisor Approval Verification QC / QA Coordinator Approval	
Root Cause		FAULT CATEGORY							
Environment ☐	No Re-verification ☐	Pressure/Forced ☐	Temperature/Cure ☐	Power Loss/Surge ☐	Positioned Wrong ☐				
Design ☐	Operator ☐	Bending ☐	Set-up ☐	Folio/Program ☐	Outside Dimensions ☐				
Doc/Data ☐	Offset/Setup ☐	Centre Not Concentric ☐	BOM/Route ☐	Grain ☐	Over/Under tolerance ☐				
Equip/Tooling ☐	Supplier ☐	Cracks ☐	Broken/Damage/Defect ☐	Weld ☐	Part Incorrect ☐				
Handling/Pre ☐	Training ☐	Crimp/Kink/Ripple/Wave ☐	Inspection Incomplete/Unqualified ☐	Wrong Stock Pulled ☐	Part Lost/Missing ☐				
Material ☐	Use for Testing ☐	Cuffs ☐	Contamination ☐	Out of Sequence ☐	Part Moved ☐				
Internal Transport ☐	Poor Information ☐	Crushing ☐	Countersink ☐	Off-set ☐	Drawing ☐				
Tribal Knowledge ☐	Rushing ☐	Heat Treat ☐	Cut Too Short ☐	Mislabeled ☐	Finish ☐				
LOA ☐	Product Improvement ☐	Wave/Twist in Tube ☐	Instructions Incomplete/Unclear ☐	Fit/Function ☐	Misread ☐				
Substation ☐	Process Improvement ☐	Marks/Chatter ☐	Drill Holes ☐	Misaligned/off center ☐	Turning Sequence ☐				
Past Expiry Date ☐	Manufacturing Process ☐	OTHER : ☐							
Misidentified ☐	Past Due ☐								

Picklist Print

Tuesday, March 15, 2016 9:20:43 AM

Page 1

Work Order ID: 143353

143353

Parent Item: D4151-5

D4151-5

Parent Item Name: Fwd Basket Instl Stud

Start Date: 3/24/2016

Required Date: 4/1/2016

Start Qty: 20.00

Required Qty: 20.00

Comments: IPP REV:A NEW ISSUE 10-07-22 JLM VERIFIED BY:DD IPP Rev:B
11.01.21 as per dwg revC DD verf:JLM

Component Item ID/ Item Name	Replacement Item ID	Mfg/ Purch	Bin Item	Primary Location	Last Location	Route Seq ID	Unit of Measure	Qty on Hand	Qty per Kit	Total Qty	Qty Issued	Date Issued	Status
M303R1.000		Purchased		No		110	f	22.6400	0.25	5.263158			

M303R1 000

303 Round Bar 1.00

Location	Loc Qty	Loc Code
MAT	0.351	
m133265	0.351	
MAT028	22.289	
m132320	5.487	
m134058	12	
m134284	4.802	
<u>m137551</u>		

3,189 ~~3,189~~
3,351 ~~3,351~~
DAS
45 2016-4-6
9-89
6.541+

DQA: _____ Date: _____




WORK ORDER NON-CONFORMANCE / UPDATE


QA Closed: _____ Date: _____

Work Order update only ☐

Work Order: _____ Part No. _____ NCR No. _____		DISPOSITION Rework ☐ Scrap ☐ Use-as-is ☐ Suspected Unapproved ☐		AGAINST DEPARTMENT/PROCESS Skid-tube ☐ Machining ☐ Thermoforming ☐ Large Fab ☐ Cross tube ☐ Small Fab ☐ Finishing ☐ Composite ☐ Water Jet ☐ Prod. Eng. Coord. ☐ Rec/Store/Packaging ☐ Supplier ☐ Engineering ☐ Quality ☐ Other ☐					
Date : _____		Step # : _____		QTY Effective : _____				MRB (QS1042) Approval	
Description Work Order Deviation				Disposition				Completed By	
								Lead hand / Supervisor Approval Verification	
								QC / QA Coordinator Approval	
Root Cause		FAULT CATEGORY							
Environment ☐	No Re-verification ☐	Pressure/Forced ☐	Temperature/Cure ☐	Power Loss/Surge ☐	Positioned Wrong ☐				
Design ☐	Operator ☐	Bending ☐	Set-up ☐	Folio/Program ☐	Outside Dimensions ☐				
Doc/Data ☐	Offset/Setup ☐	Centre Not Concentric ☐	BOM/Route ☐	Grain ☐	Over/Under tolerance ☐				
Equip/Tooling ☐	Supplier ☐	Cracks ☐	Broken/Damage/Defect ☐	Weld ☐	Part Incorrect ☐				
Handling/Pre ☐	Training ☐	Crimp/Kink/Ripple/Wave ☐	Inspection Incomplete/Unqualified ☐	Wrong Stock Pulled ☐	Part Lost/Missing ☐				
Material ☐	Use for Testing ☐	Cuffs ☐	Contamination ☐	Out of Sequence ☐	Part Moved ☐				
Internal Transport ☐	Poor Information ☐	Crushing ☐	Countersink ☐	Off-set ☐	Drawing ☐				
Tribal Knowledge ☐	Rushing ☐	Heat Treat ☐	Cut Too Short ☐	Mislabeled ☐	Finish ☐				
LOA ☐	Product Improvement ☐	Wave/Twist in Tube ☐	Instructions Incomplete/Unclear ☐	Fit/Function ☐	Misread ☐				
Substation ☐	Process Improvement ☐	Marks/Chatter ☐	Drill Holes ☐	Misaligned/off center ☐	Turning Sequence ☐				
Past Expiry Date ☐	Manufacturing Process ☐	OTHER : _____							
Misidentified ☐	Past Due ☐								

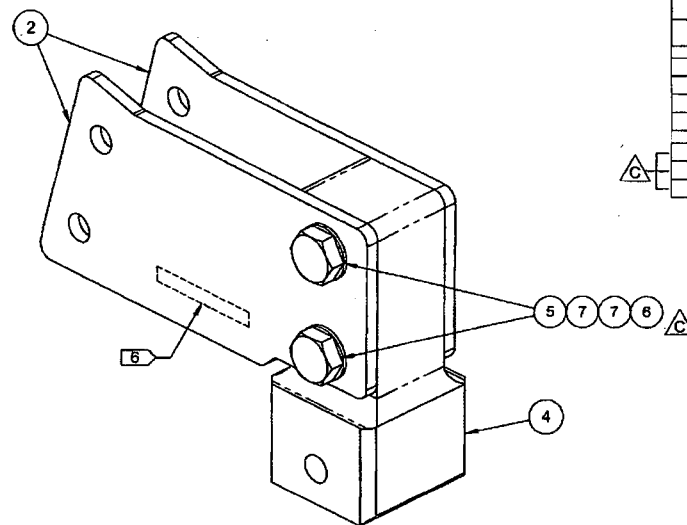

D4151-043 BASKET FWD HARDPOINT ASSY (UPPER)

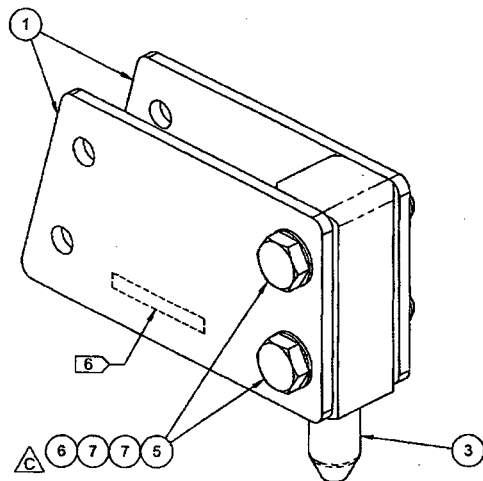

D4151-041 BASKET FWD HARDPOINT ASSY (LOWER)

NOTES:

- 1) MATERIAL: N/A
- 2) FINISH: NONE
- 3) TOLERANCES: PER DART QSI 018 UNLESS OTHERWISE NOTED
- 4) UNITS: INCHES UNLESS OTHERWISE NOTED
- 5) BREAK SHARP EDGES: 0.005 TO 0.010 MAX
- 6) IDENTIFICATION: IDENTIFY WITH DART P/N "D4151-04X" USING FINE POINT PERMANENT INK MARKER
- 7) WEIGHT:
 - D4151-041 = 0.88 lbs
 - D4151-043 = 1.17 lbs

ITEM	QTY -041	QTY -043	P/N	DESCRIPTION
	X		D4151-041	BASKET FWD HARDPOINT ASSY (LOWER)
		X	D4151-043	BASKET FWD HARDPOINT ASSY (UPPER)
1	2		D4151-1	LOWER HARDPOINT PLATE
2		2	D4151-3	UPPER HARDPOINT PLATE
3	1		D4151-5	FWD BASKET INSTL STUD (LOWER)
4		1	D4151-7	FWD EYEBOLT RECEIVER (UPPER)
5	2	2	AN4C13A	BOLT
6	2	2	MS21043-4	NUT
7	4	4	NAS1149C0432R	WASHER

SHOP COPY
RETURN TO
ENGINEERING
UNCONTROLLED COPY
SUBJECT TO AMENDMENT
WITHOUT NOTICE
WORK ORDER

NO. 143355 ML5
1603-15

RELEASED
2011-01-18



C	AM4 HARDWARE WAS AN3 (B8-1, C3-1 & D3-1); Ø0.252 WAS Ø0.191 (C5-2, D1-2); TIGHTENED TOL ON 1.000 DIM (C5-2, D1-2, C7-3, C3-3); Ø0.250 WAS Ø0.191 (C8-3, B4-3); 1.83 WAS 1.75 (C1-2), 2.84 WAS 2.78 (B3-3) AND 1.88 WAS 1.80 (C1-3) TO PRESERVE 1.5SD. REASON: SEE D407-797 DESIGN JOURNAL	MB	10.12.14
B	ADDED D4151-5/7 (SHT 3); D4151-5 WAS D3911-1 (ZN B6-1 & D3-1); D4151-7 WAS D3911-3 (ZN C4-1 & D3-1) ITEMS #5, 6 & 7 REPLACE MS20615-4M20 (ZN C3-1, D3-1 & B8-1); Ø0.191 2 PL REPLACES Ø0.129 3 PL (ZN C5-2); Ø0.191 2 PL REPLACES Ø0.129 4 PL (ZN D1-2). REASON: SEE TR-0350-007-2 REV. B.	MB	10.07.05
A	NEW ISSUE	MB	10.06.22
REV.	DESCRIPTION	BY	DATE
DESIGN			
DRAWN			
CHECKED			
MFG. APPR.			
APPROVED			
DE APPR.			
DATE	10.12.14		

DART AEROSPACE LTD
HAWKESBURY, ONTARIO, CANADA

DRAWING NO. **D4151** REV. C
SHEET 1 OF 3

TITLE **BASKET FWD HARDPOINT** SCALE NTS


COPYRIGHT © 2010 BY DART AEROSPACE LTD
THIS DOCUMENT IS PRIVATE AND UNCLASSIFIED AND IS SUPPLIED ON THE EXPRESS UNDERSTANDING THAT IT IS NOT TO BE USED FOR ANY PURPOSE OR FOR REPRODUCTION TO ANY OTHER PERSON WITHOUT WRITTEN PERMISSION FROM DART AEROSPACE LTD.

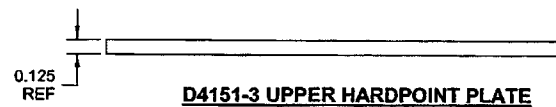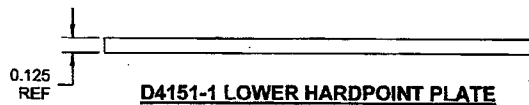


2) FINISH: NONE
3) TOLERANCES: PER DART QSI 018 UNLESS OTHERWISE NOTED
4) UNITS: INCHES UNLESS OTHERWISE NOTED
5) BREAK SHARP EDGES: 0.005 TO 0.010 MAX
6) IDENTIFICATION: IDENTIFY AT ASSEMBLY
7) WEIGHT:
- D4151-1 = 0.24 lbs
- D4151-3 = 0.23 lbs

RELEASED
2011-01-18
MD


DESIGN	<i>16</i>	DART AEROSPACE LTD	
DRAWN	<i>16</i>	HAWKESBURY, ONTARIO, CANADA	
CHECKED	<i>SC</i>	DRAWING NO.	REV. <i>1</i>
MFG. APPR.	<i>AD</i>	D4151	SHEET 2 OF 2
APPROVED	<i>MT</i>	TITLE	SCALE
DE APPR.	<i>MT</i>	BASKET FWD HARDPOINT	NTS
DATE	10.12.14	COPYRIGHT © 2010 BY DART AEROSPACE LTD THIS DOCUMENT IS PROPRIETARY AND CONFIDENTIAL. WHO IS SUPPLIED TO THE CUSTOMER UNDER THE PROVISION THAT IT IS NOT TO BE USED FOR ANY PURPOSE OR COPIED OR COMMUNICATED TO ANY OTHER PERSON WITHOUT THE WRITTEN PERMISSION OF DART AEROSPACE LTD.	

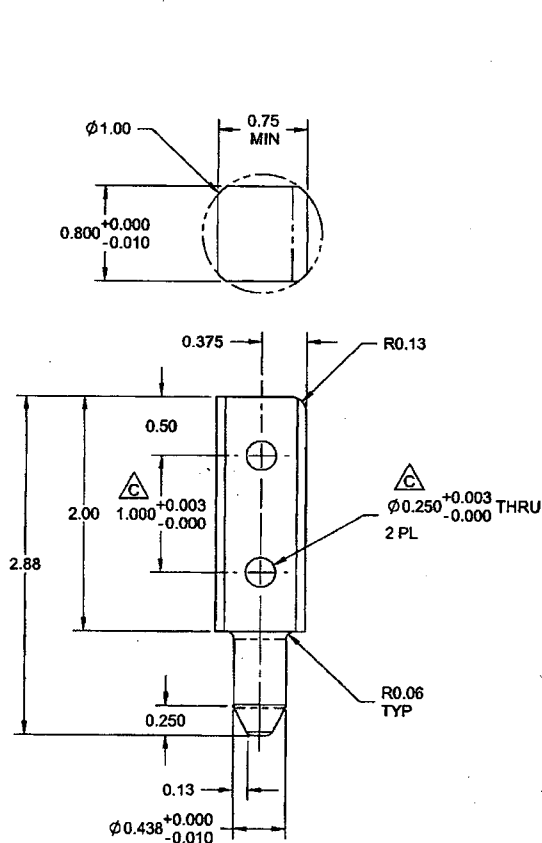

D4151-5 FWD BASKET INSTL STUD (LOWER)

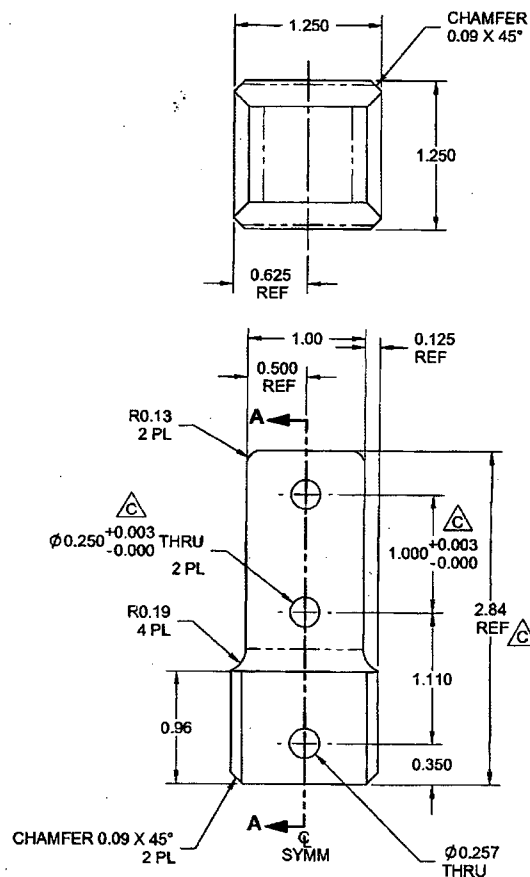

D4151-7 FWD EYEBOLT RECEIVER (UPPER)

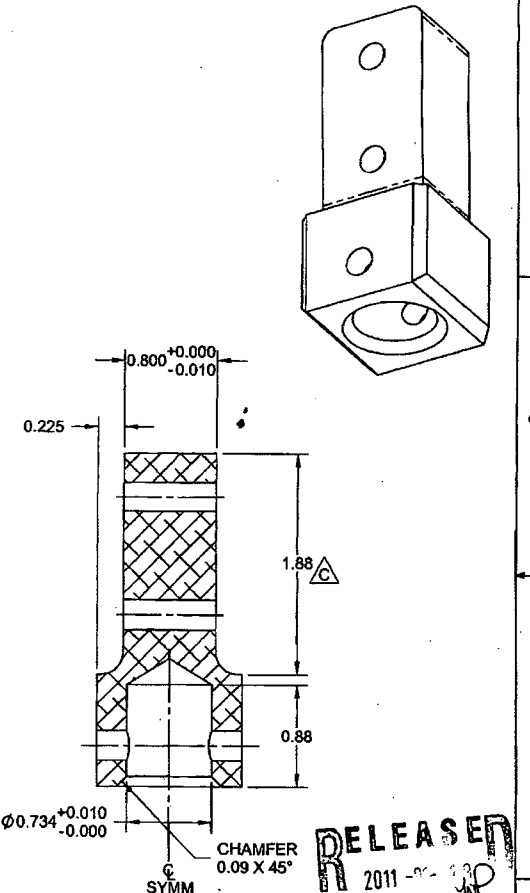

SECTION A-A

- NOTES:**
- 1) MATERIAL -5: 303/304/316 STAINLESS STEEL ROUND BAR, PER ASTM A276 OR ASTM A582 PER DART SPEC M303R OR M304R
 - 7: 303/304/316 STAINLESS STEEL BAR, PER ASTM A276 OR ASTM A582 PER DART SPEC M303B OR M304B
 - 2) FINISH: NONE
 - 3) TOLERANCES: PER DART QSI 018 UNLESS OTHERWISE NOTED
 - 4) UNITS: INCHES UNLESS OTHERWISE NOTED
 - 5) BREAK SHARP EDGES: 0.005 TO 0.010 MAX
 - 6) IDENTIFICATION: IDENTIFY AT ASSEMBLY
 - 7) WEIGHT -5: 0.36 lbs
-7: 0.70 lbs

DESIGN	15	DART AEROSPACE LTD	
DRAWN	15	HAWKESBURY, ONTARIO, CANADA	
CHECKED	Sc	DRAWING NO.	REV. C
MFG. APPR.		D4151	SHEET 3 OF 3
APPROVED	MS	TITLE	SCALE
DE APPR.	HL	BASKET FWD HARDPOINT	NTS
DATE	10.12.14	COPYRIGHT © 2010 BY DART AEROSPACE LTD	
THIS DOCUMENT IS PRIVATE AND CONFIDENTIAL AND IS SUPPLIED ON THE EXPRESS UNDERSTANDING THAT IT IS NOT TO BE USED FOR ANY PURPOSE OR COPIED OR COMMUNICATED TO ANY OTHER PERSON WITHOUT WRITTEN PERMISSION FROM DART AEROSPACE LTD.			

RELEASED
2011-01-13
RELEASED